


**ROOM LAYOUT AS BUILT**  
**PRESIDENTIAL ATRIUM LEVEL 1**  
**SCALE 1:150**

**Capacity: 150 pax.**  
**Function Type: Cocktail**  
**Area: +- 450m<sup>2</sup>**

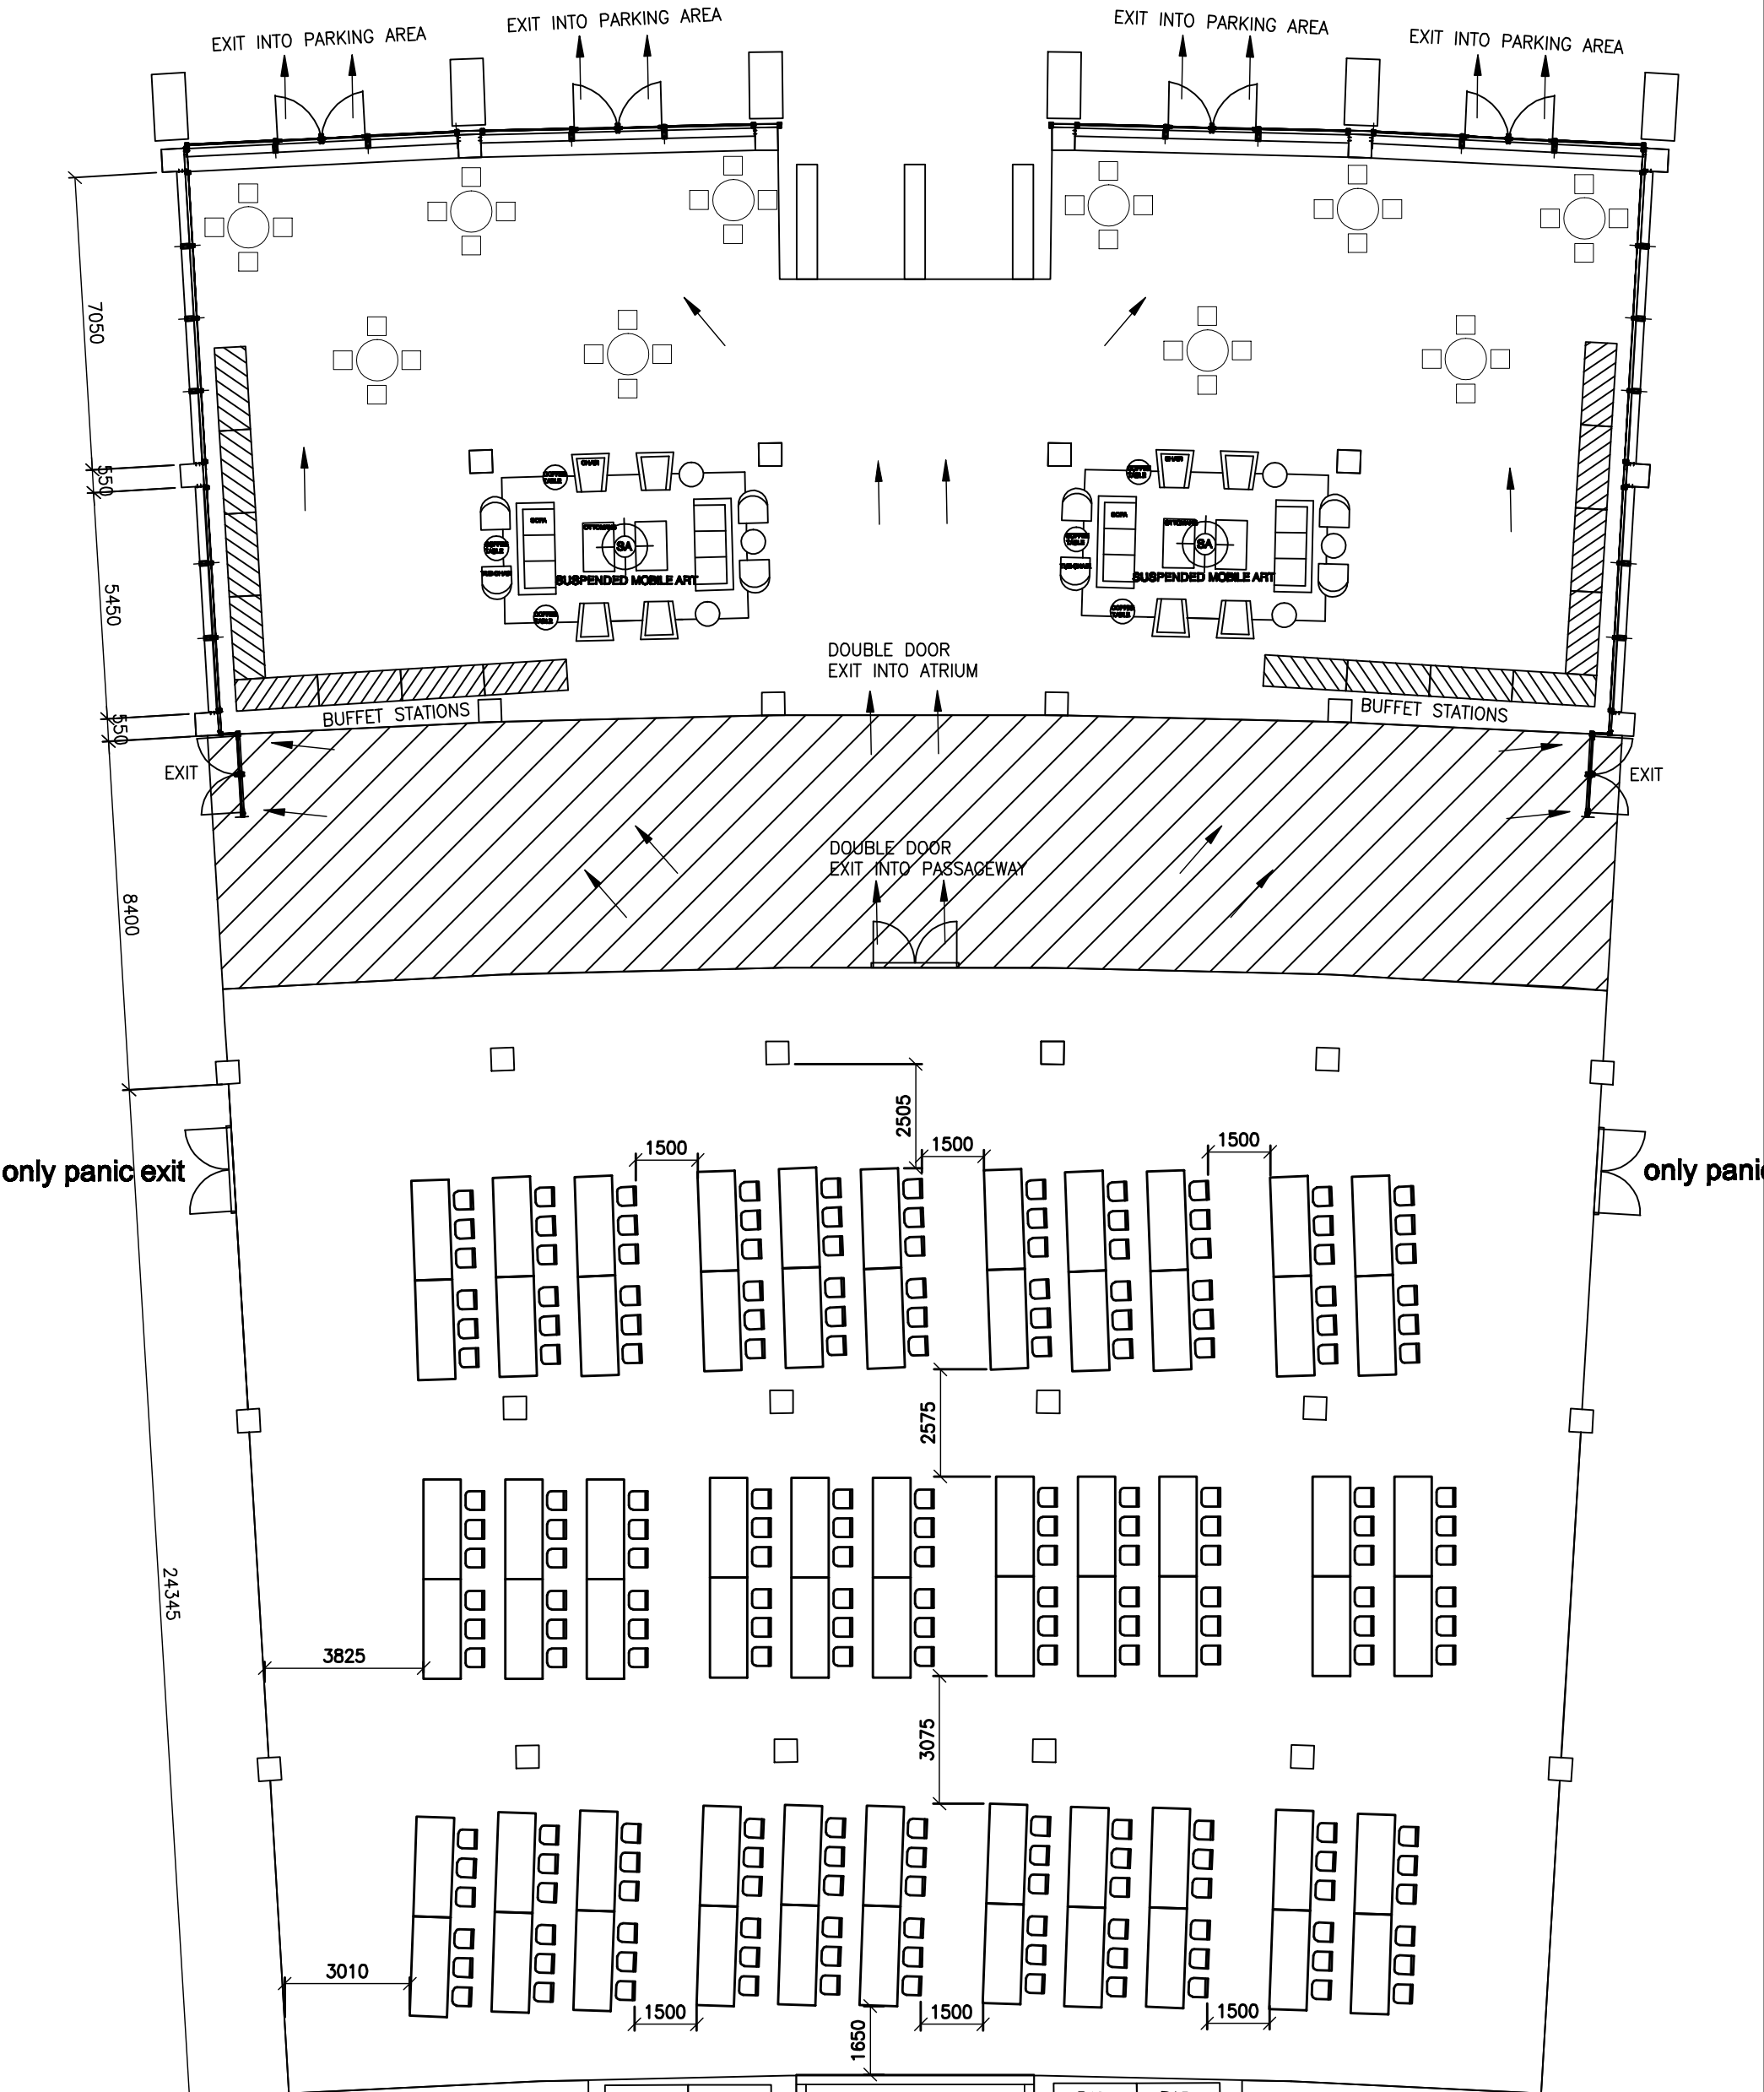

**Capacity: 200pax.**  
**Function Type: Conference 2**  
**Area: +- 770m<sup>2</sup>**

BAR BAR

EXIT ONTO FIELD  
5255

BAR BAR

**ROOM LAYOUT AS BUILT**  
**MIXED ZONE LEVEL 1**  
**SCALE 1:150**