


ROOM LAYOUT AS BUILT
PRESIDENTIAL ATRIUM LEVEL 1
SCALE 1:150

Capacity: 150 pax.
Function Type: Cocktail
Area: +- 450m²

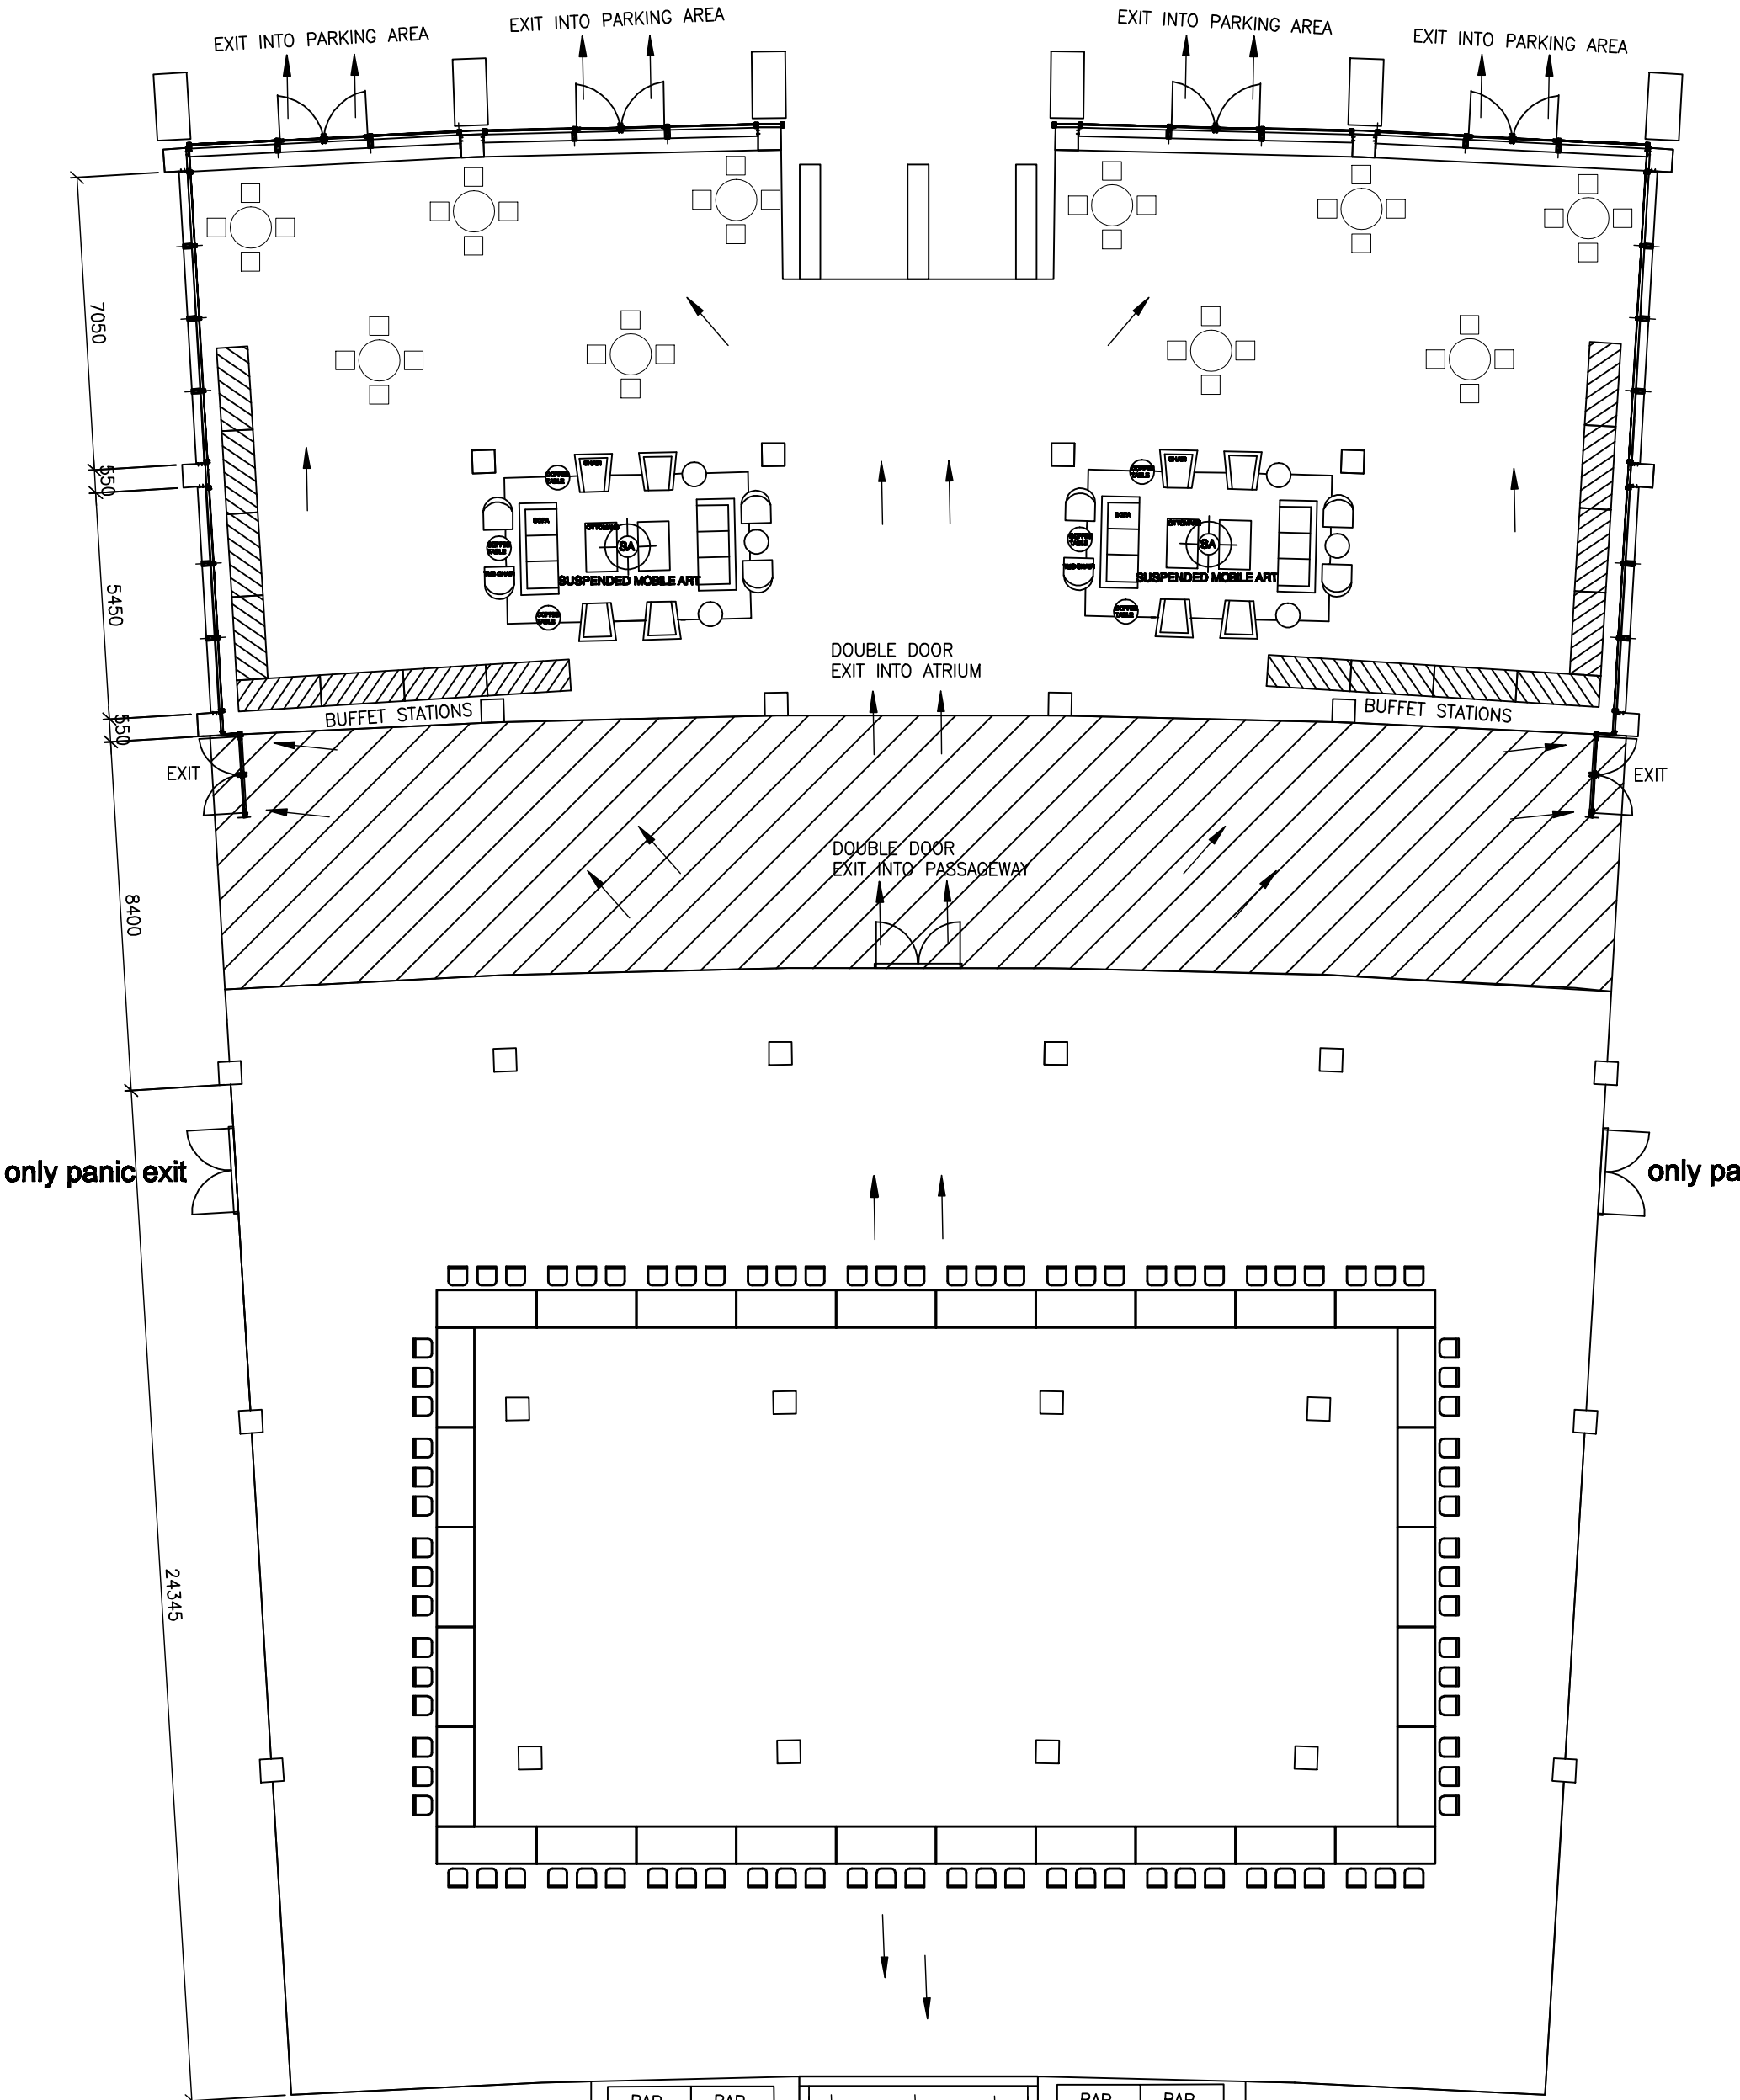

Capacity: 90pax.
Function Type: square 1
Area: +- 770m²

BAR BAR

EXIT ONTO FIELD
5255

BAR BAR

ROOM LAYOUT AS BUILT
MIXED ZONE LEVEL 1
SCALE 1:150