



ROOM LAYOUT AS BUILT
PRESIDENTIAL ATRIUM LEVEL 1
SCALE 1:150

Capacity: 150 pax.
Function Type: Cocktail
Area: +- 450m²

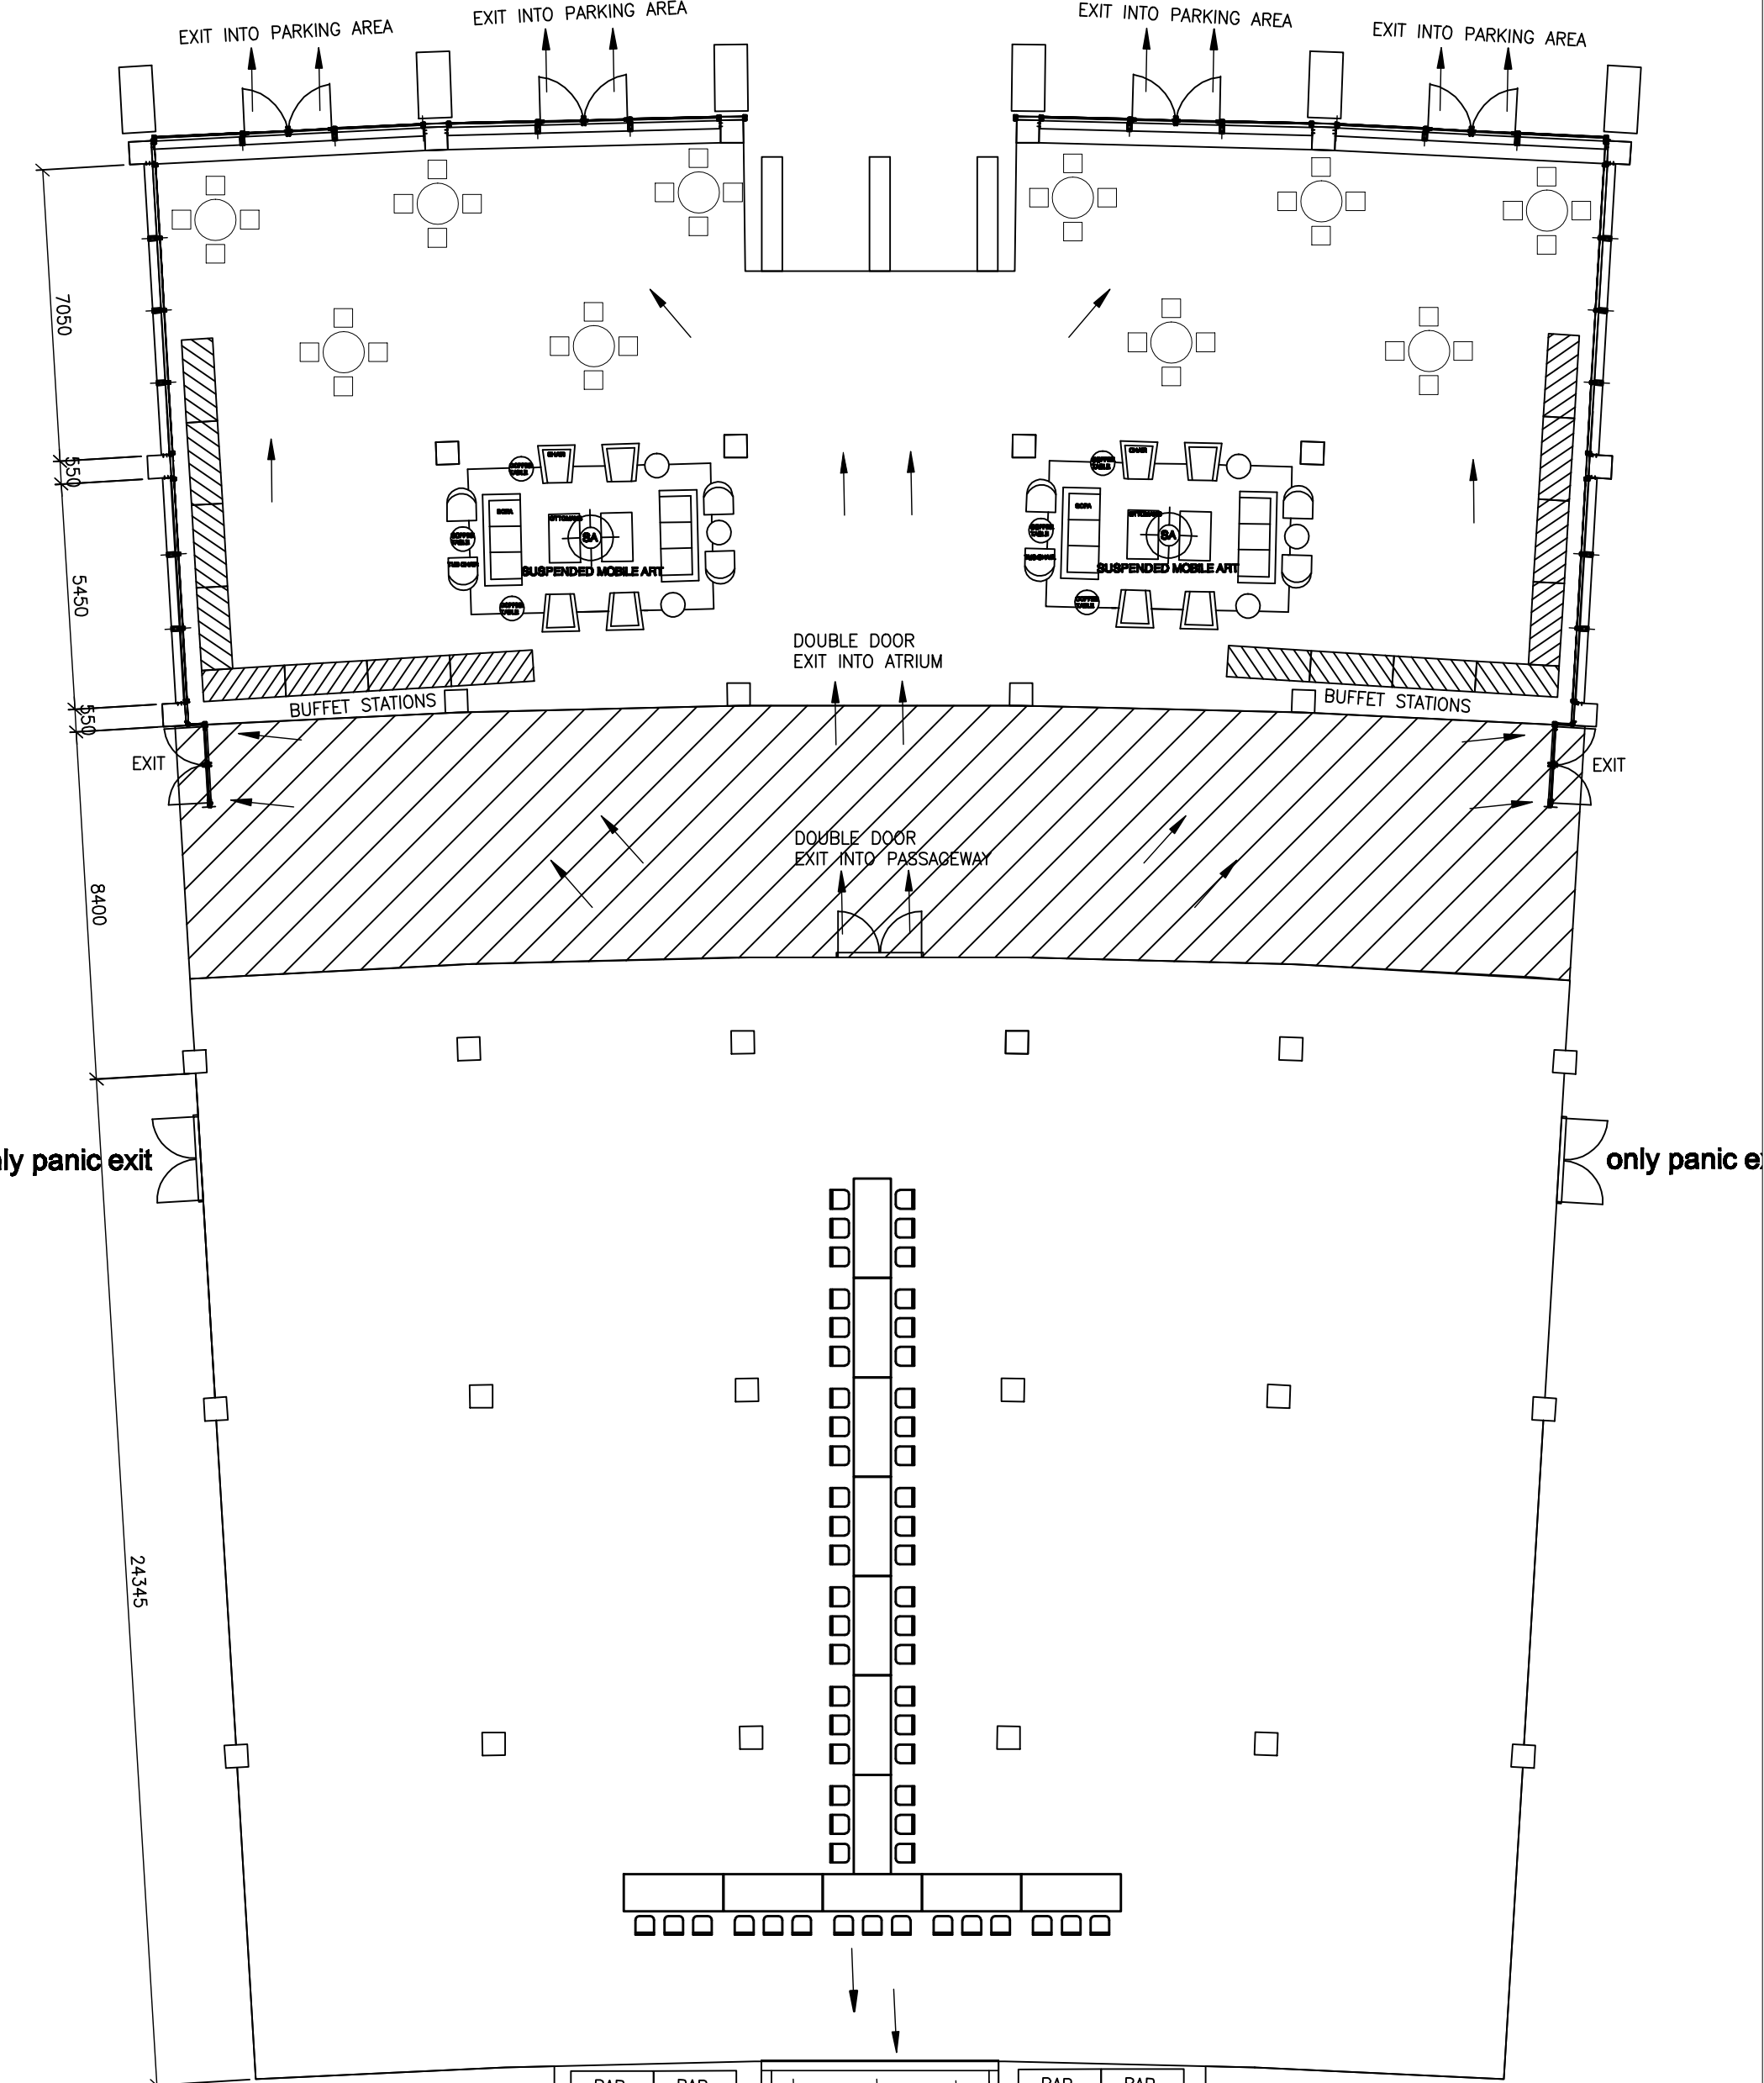

Capacity: 60pax.
Function Type: T SHAPE
Area: +- 770m²

BAR BAR

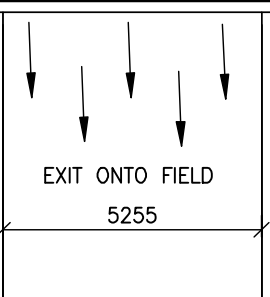

BAR BAR

ROOM LAYOUT AS BUILT
MIXED ZONE LEVEL 1
SCALE 1:150